

# BALSAM GROVE VFD PUMPER/TANKER

TID NO. 13845



## BODY

- Bolted Painted Stainless Steel Body
- Roll Up Doors
- Rear Slide-In Ladder and Pike Pole Storage
- Above Compartment Hard Suction Storage
- Storage for 4 SCBA Bottles in Wheel Wells
- Rear Mounted Ladder for Easy Hosebed Access
- Rear Mounted Tow Hooks
- In-Compartment Slide-Out SCBA Brackets



## CHASSIS

- Freightliner SD114 2-Door Chassis
- Detroit DD13 525 HP Engine
- 4000 EVS Transmission
- Back-Up Camera
- Custom Lettering and Striping



## TANK

- 2000 Gallon UPF Tank
- ICI SL Plus Tank Gauge
- Syntex 2100 Gallon Portable Tank
- Zico Hydraulic Painted Porta-Tank Rack
- (2) Rear 2.5" Direct Tank Fills
- Rear Manual Dump Chute



## PUMP




- Hale MBP 1000 GPM Pump
- FRC In Control 400 Pressure Governor
- (2) 1.75" Crosslays
- Left side: (2) 2.5" Discharges  
2.5" Intake  
Master Intake
- Right side: (2) 2.5" Discharges  
Master Intake
- Hosebed 2.5" Discharge
- Piped for Monitor



## ELECTRICAL

- ILLI LED Strip Compartment Lighting
- Whelen Warning Lighting
- FRC LED 900-Q65 Scene Lights
- Fire Tech Hi Viz 46" LED Brow Light

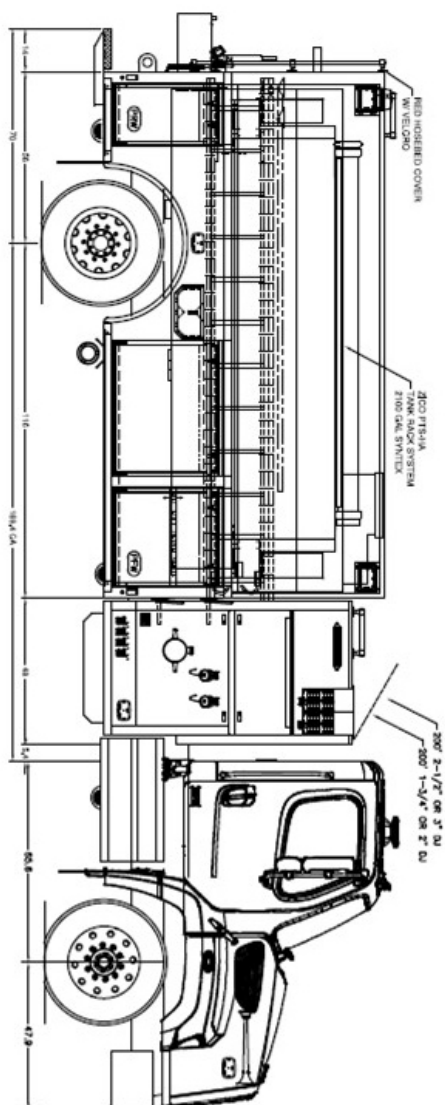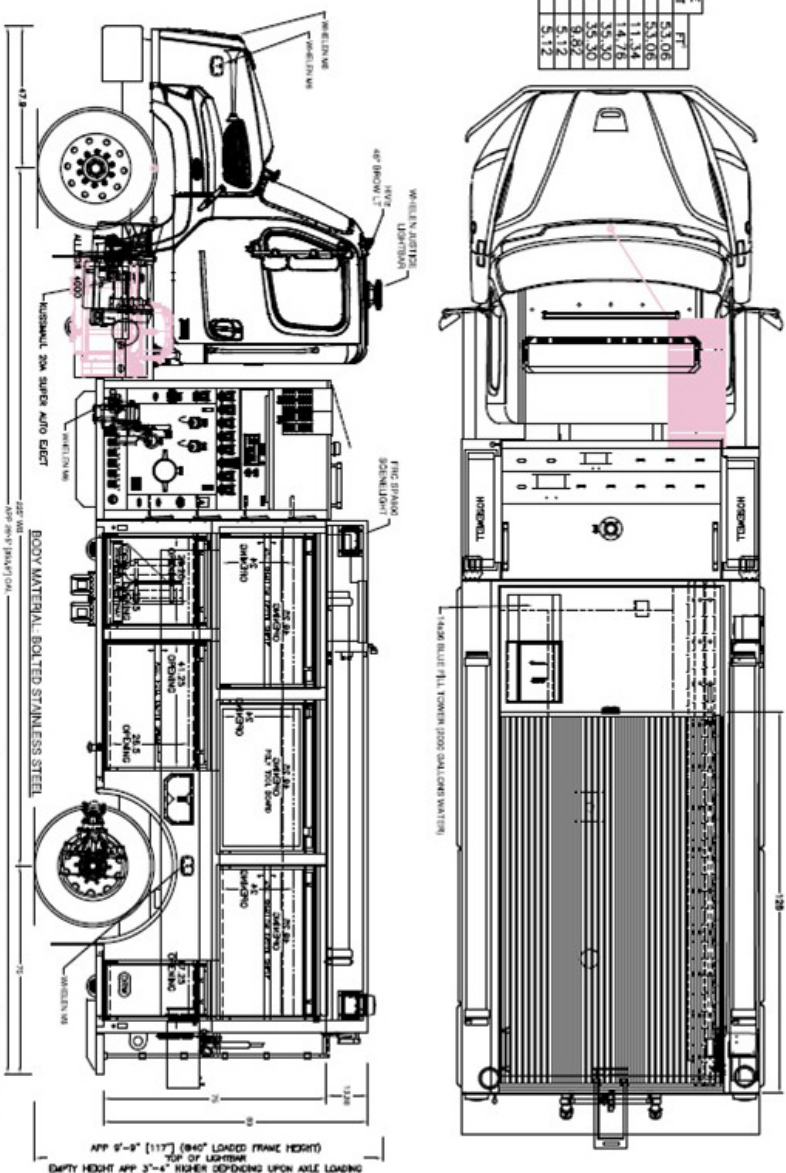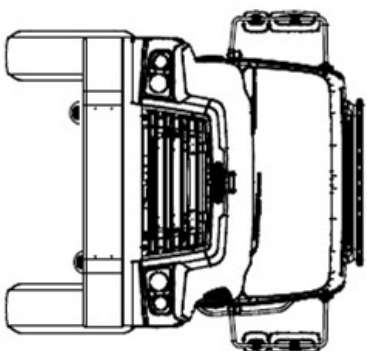

[illegible]

APP 3'-8" [117"] (840° LOADED FRAME HEIGHT)  
TOP OF LIGHTBAR  
EMPTY HEIGHT APP 3'-4" HIGHER (DEPENDING UPON AXLE LOADING)

DIMENSIONS SHOWN ARE APPROXIMATE AND ARE SUBJECT TO MINOR CHANGE AS MAY BE FOUND NECESSARY DURING CONSTRUCTION. MINOR DETAILS MAY NOT BE SHOWN, IF DISCREPANCIES EXIST BETWEEN THIS DRAWING AND THE WRITTEN SPECIFICATIONS PROVIDED BY TOWNE, THE WRITTEN SPECIFICATIONS SHALL PREVAIL.

|                  |         |              |                             |             |               |
|------------------|---------|--------------|-----------------------------|-------------|---------------|
| ORIGINAL DRAWING | 13APR22 | CHASSIS:     | FRESH TUNER S01145BA 2 DOOR | SCALE: 1/66 | SHEET         |
| REV A            | 08ALG22 | WB-C-A-F:    | 235-169,4'-55" D17          | CITY:       | BALSAM GROVE  |
| BR               | 06ALG23 | BODY MATL:   | BOLTED STAINLESS STEEL      | STATE:      | NC            |
| CO 1             | 2 JUL22 | PUMP:        | HALE MP 1000                | DUR:        | MEL           |
| CO 2             | 17JUL22 | TANK:        | 2000 UFF POLY-TANK III      | CAP:        | GROSSMAN      |
| AS BUILT: ANDY   | 18JUL22 | FOAM SYSTEM: | N/A                         | DATE:       | 13 APR 2022   |
|                  |         | GENERATOR:   | N/A                         | FILE:       | BALSAMGROVE22 |



**BREDA, IA 51436**  
**800-648-3358**

**BALSAM GROVE**  
CUSTOM TRANSPORTER